
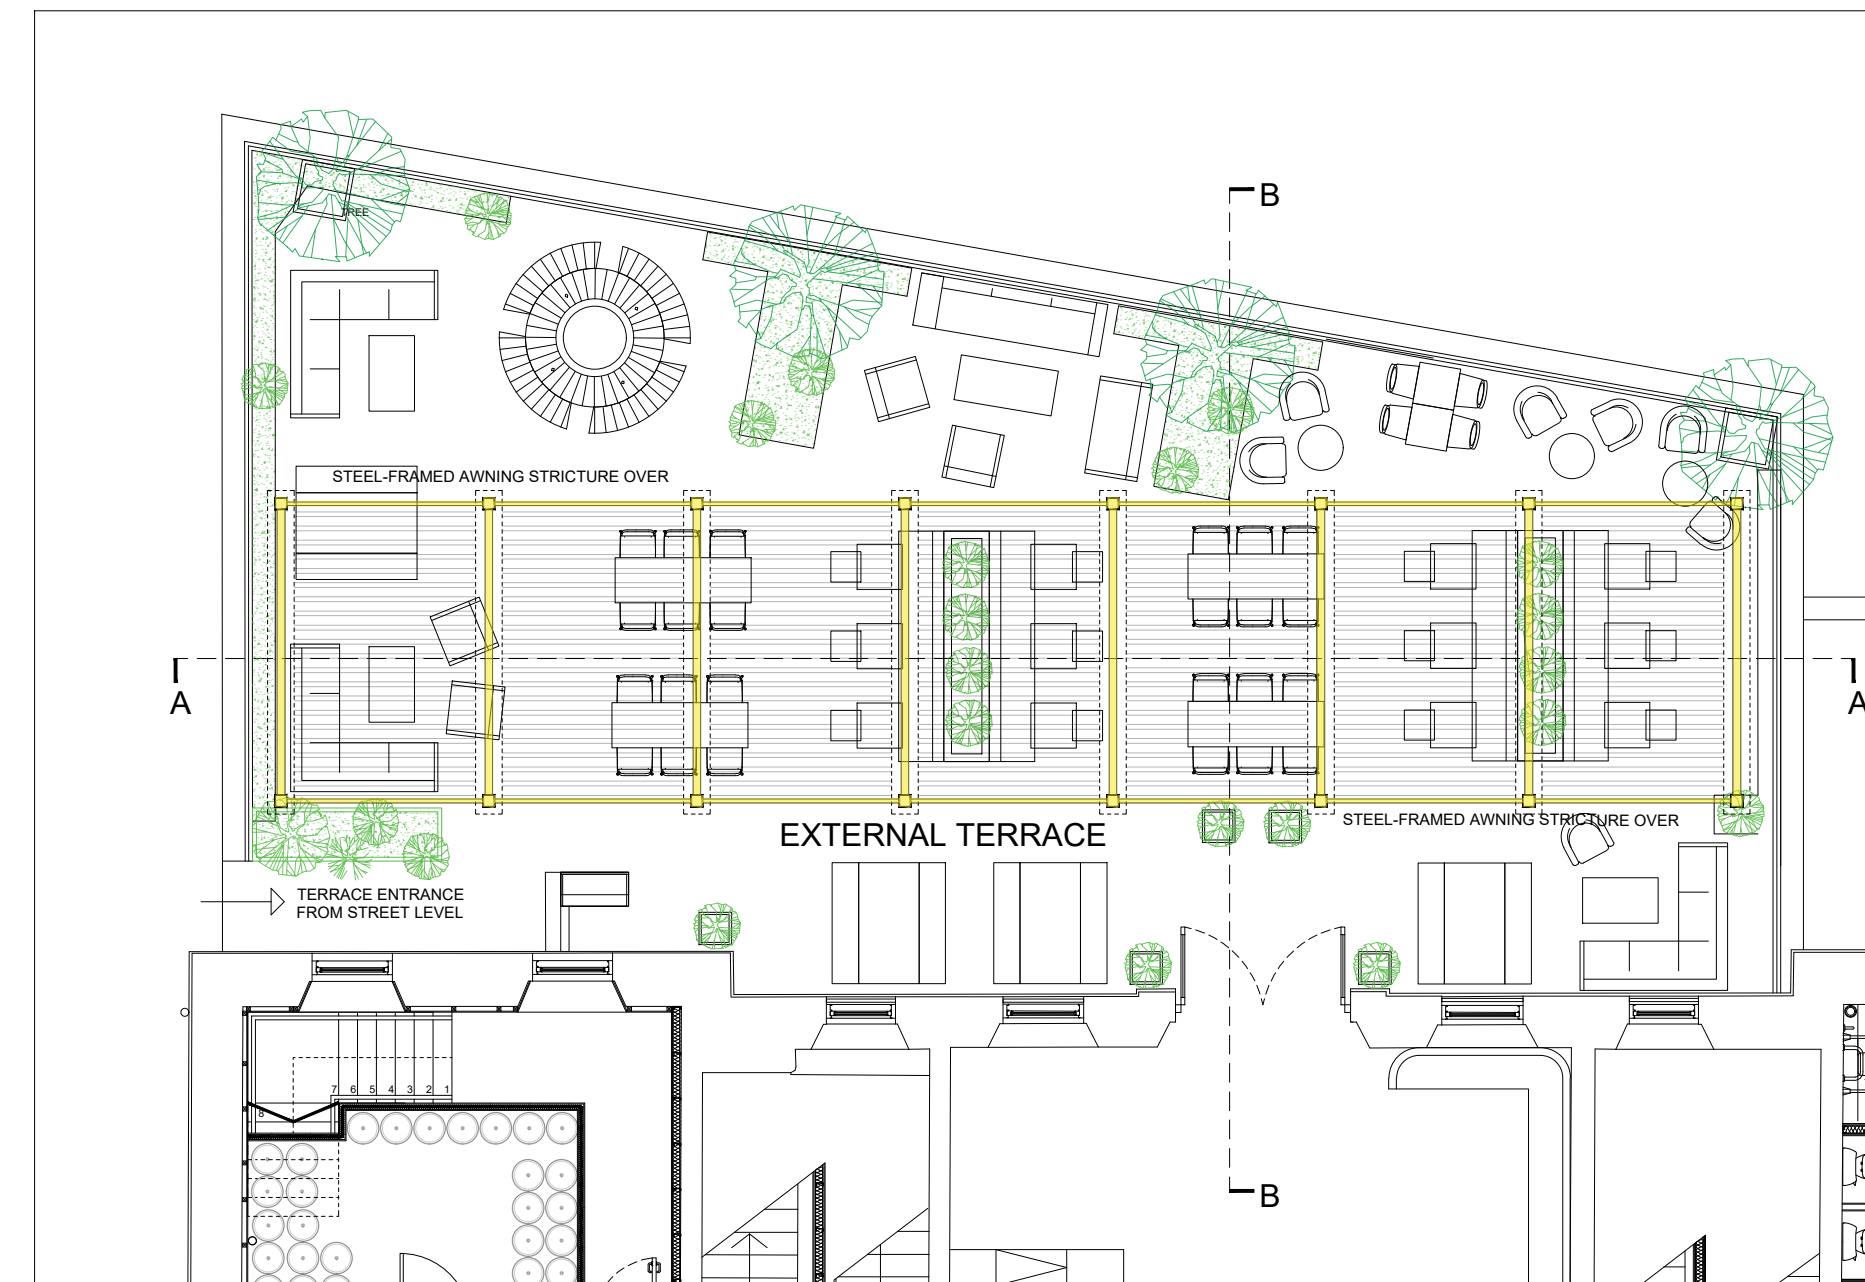



typical section through canopy

scale 1: 25 @ A1

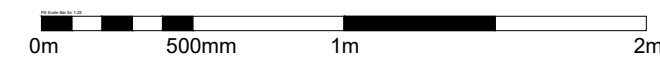

external terrace plan - as built

scale 1: 100 @ A1

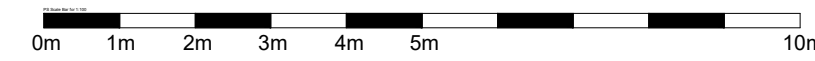

SHADING INDICATES NEW WORKS

DO NOT SCALE FROM DRAWINGS. USE GIVEN DIMENSIONS ONLY. ALL DIMENSIONS TO BE VERIFIED AND AGREED WITH ARCHITECT IN ACCORDANCE WITH SITE CONDITIONS PRIOR TO THE COMMENCEMENT OF ANY WORKS.

ALL SURFACE DRAWINGS ARE TO BE READ IN CONJUNCTION WITH MECHANICAL AND ELECTRICAL ENGINEERS AND STRUCTURAL ENGINEERS DRAWINGS, DETAILS AND SPECIFICATIONS WHERE RELEVANT.

ALL WORKS TO BE TO THE RELEVANT BRITISH STANDARD CODE OF PRACTICE AND MANUFACTURERS WRITTEN RECOMMENDATIONS.

ALL WORKS INCLUDING DEMOLITIONS TO BE EXECUTED SO AS NOT TO IMPAIR THE STABILITY OR ENDANGER THE BUILDING. ADJACENT WORKS, PERSONNEL OR THIRD PARTIES. ALL IN ACCORDANCE WITH ALL HSE AND STATUTORY AUTHORITIES RECOMMENDATIONS.

ELECTRICAL INSTALLATION TO COMPLY WITH CURRENT IET WIRING REGULATIONS AND WITH B.S. 7671 - 2018 INCLUDING ANY AMENDMENTS. HEATING AND VENTILATION TO SPECIALIST CONTRACTORS DESIGN TO COMPLY TO LATEST CIBSE GUIDELINES.

ALL NEW DRAINAGE TO BE CARRIED OUT STRICTLY IN ACCORDANCE WITH B.S. EN 12056-2: 2000 (SANITARY PIPEWORK), BS EN 752-3: 1997, BS EN 752-4: 1998 BS EN 1610: 1998 (DRAINAGE SYSTEM OUTWITH A BUILDING).

ALL GLAZING, GLASS, WINDOWS DOORS AND SCREENS TO COMPLY FULLY WITH B.S. 6262 AND B.S. 6206.

ALL MATERIALS AND COMPONENTS TO BE 'FIT FOR PURPOSE' AND IN FULL COMPLIANCE WITH THE CURRENT TECHNICAL STANDARDS.




front elevation - as built

scale 1: 100 @ A1




side elevation - as built

scale 1: 100 @ A1

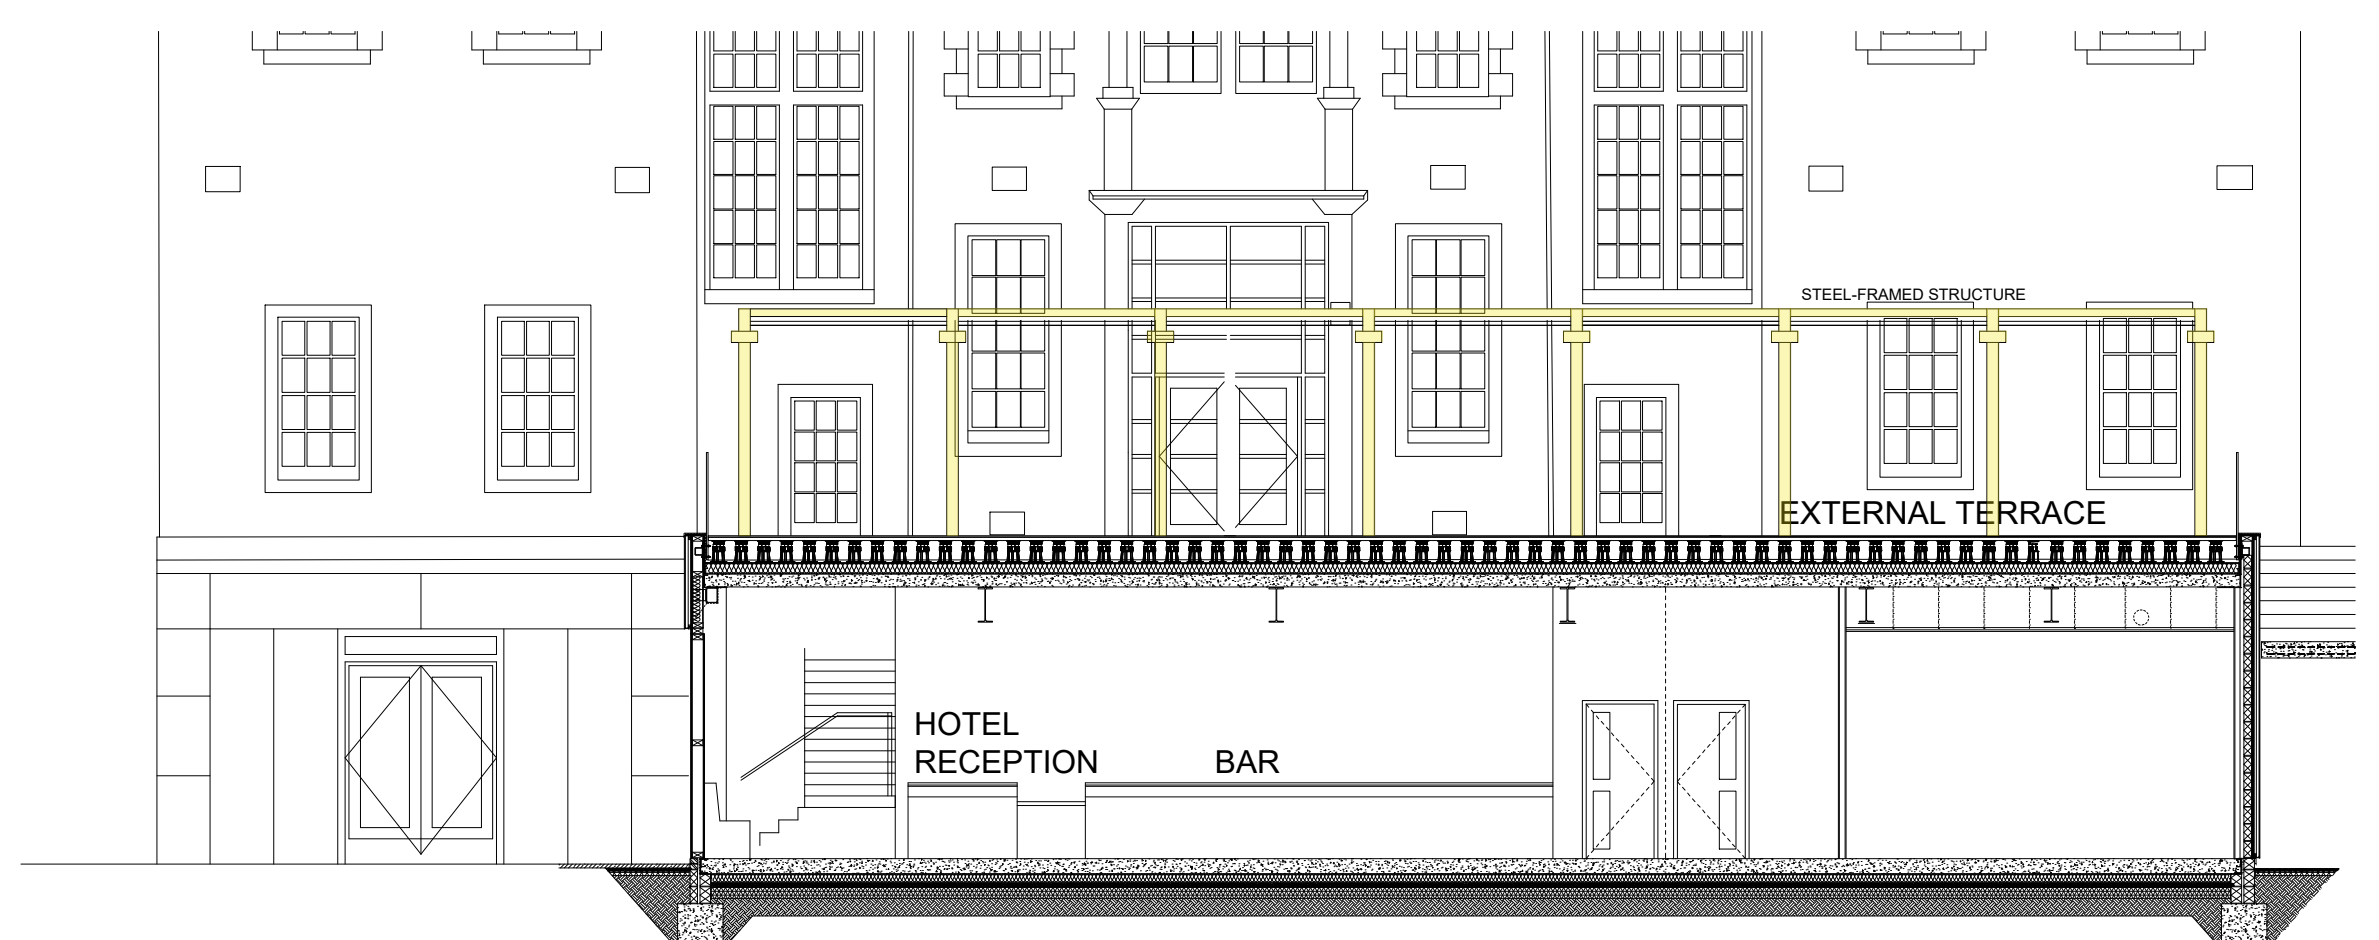

section A-A - as built

scale 1: 100 @ A1

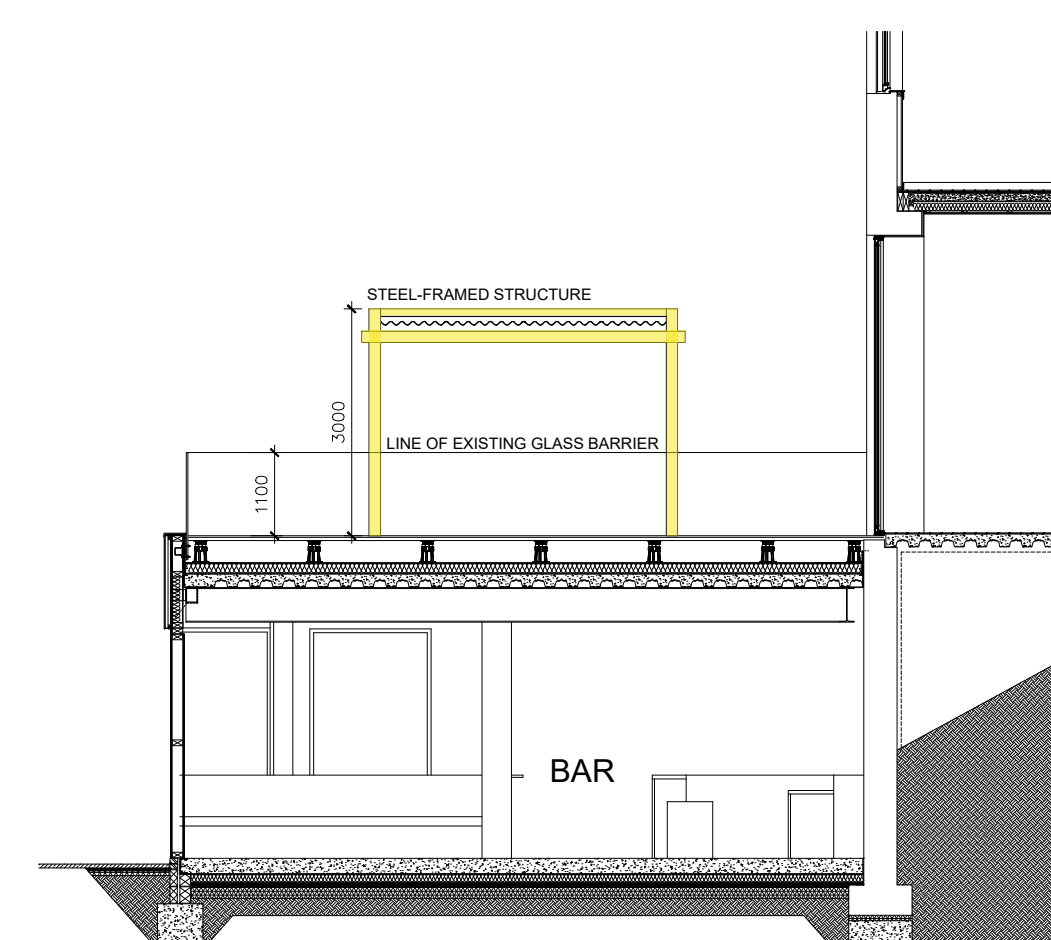

section B-B - as built

scale 1: 100 @ A1

Rev B - Aug 2022 - Layout updated - Title changed to 'As Built'
Rev A - Jul 2021 - Canopy design altered


client: BREWDOG
project: Brewdog, Cannongate
location: The Cannongate Venture Building
New Street, Edinburgh
EH8 8BH
drg title: Proposed External Canopy
Plans and Elevations As Built

scale: 1:100 & 1:200 @ A1 date: July 2021

drg no: 2908 PL 21B
status: PLANNING



surface

Surface - ID Ltd The Mews 12 Fortrose Street GLASGOW G11 5LP
tel: 0141 342 5448 fax: 0141 337 2244
mail@surface-id.com www.surface-id.com
Registered in Scotland No. SC233305

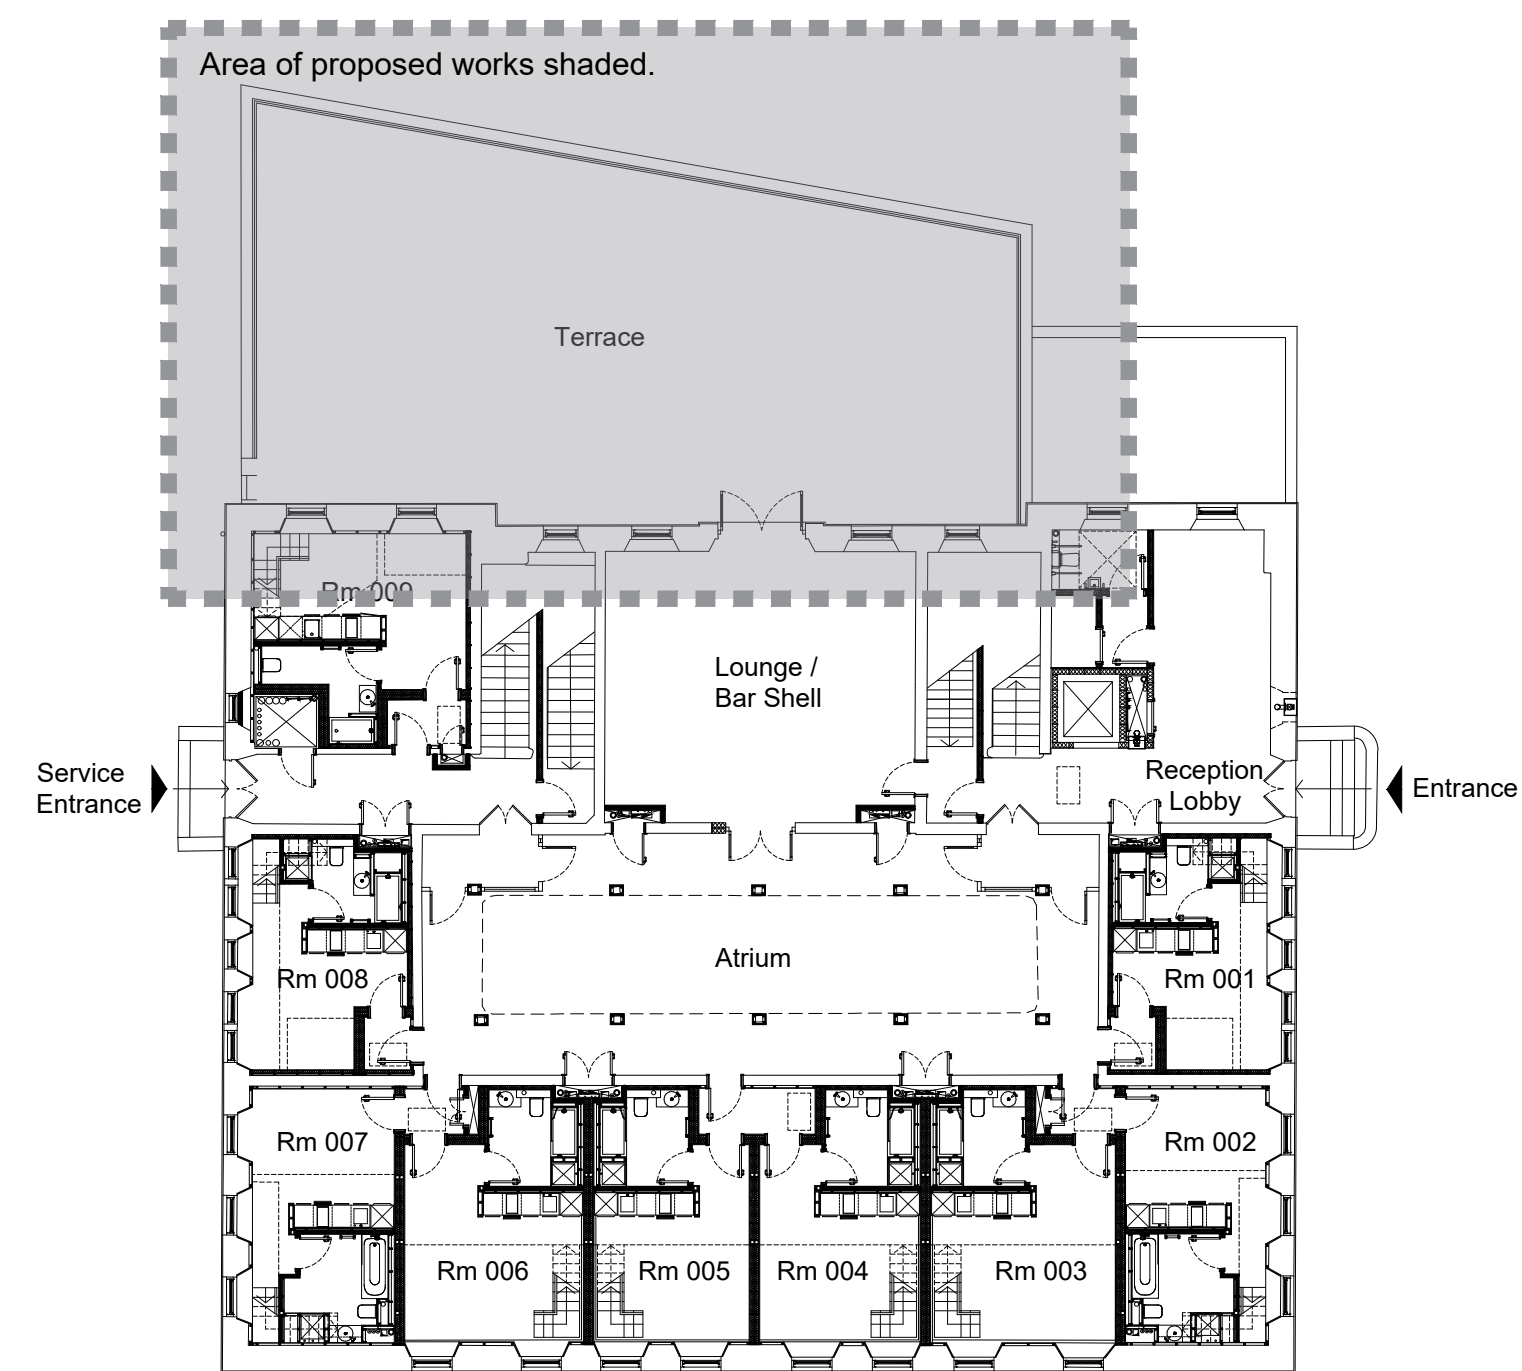


ground floor plan - as existing

scale 1: 200 @ A1

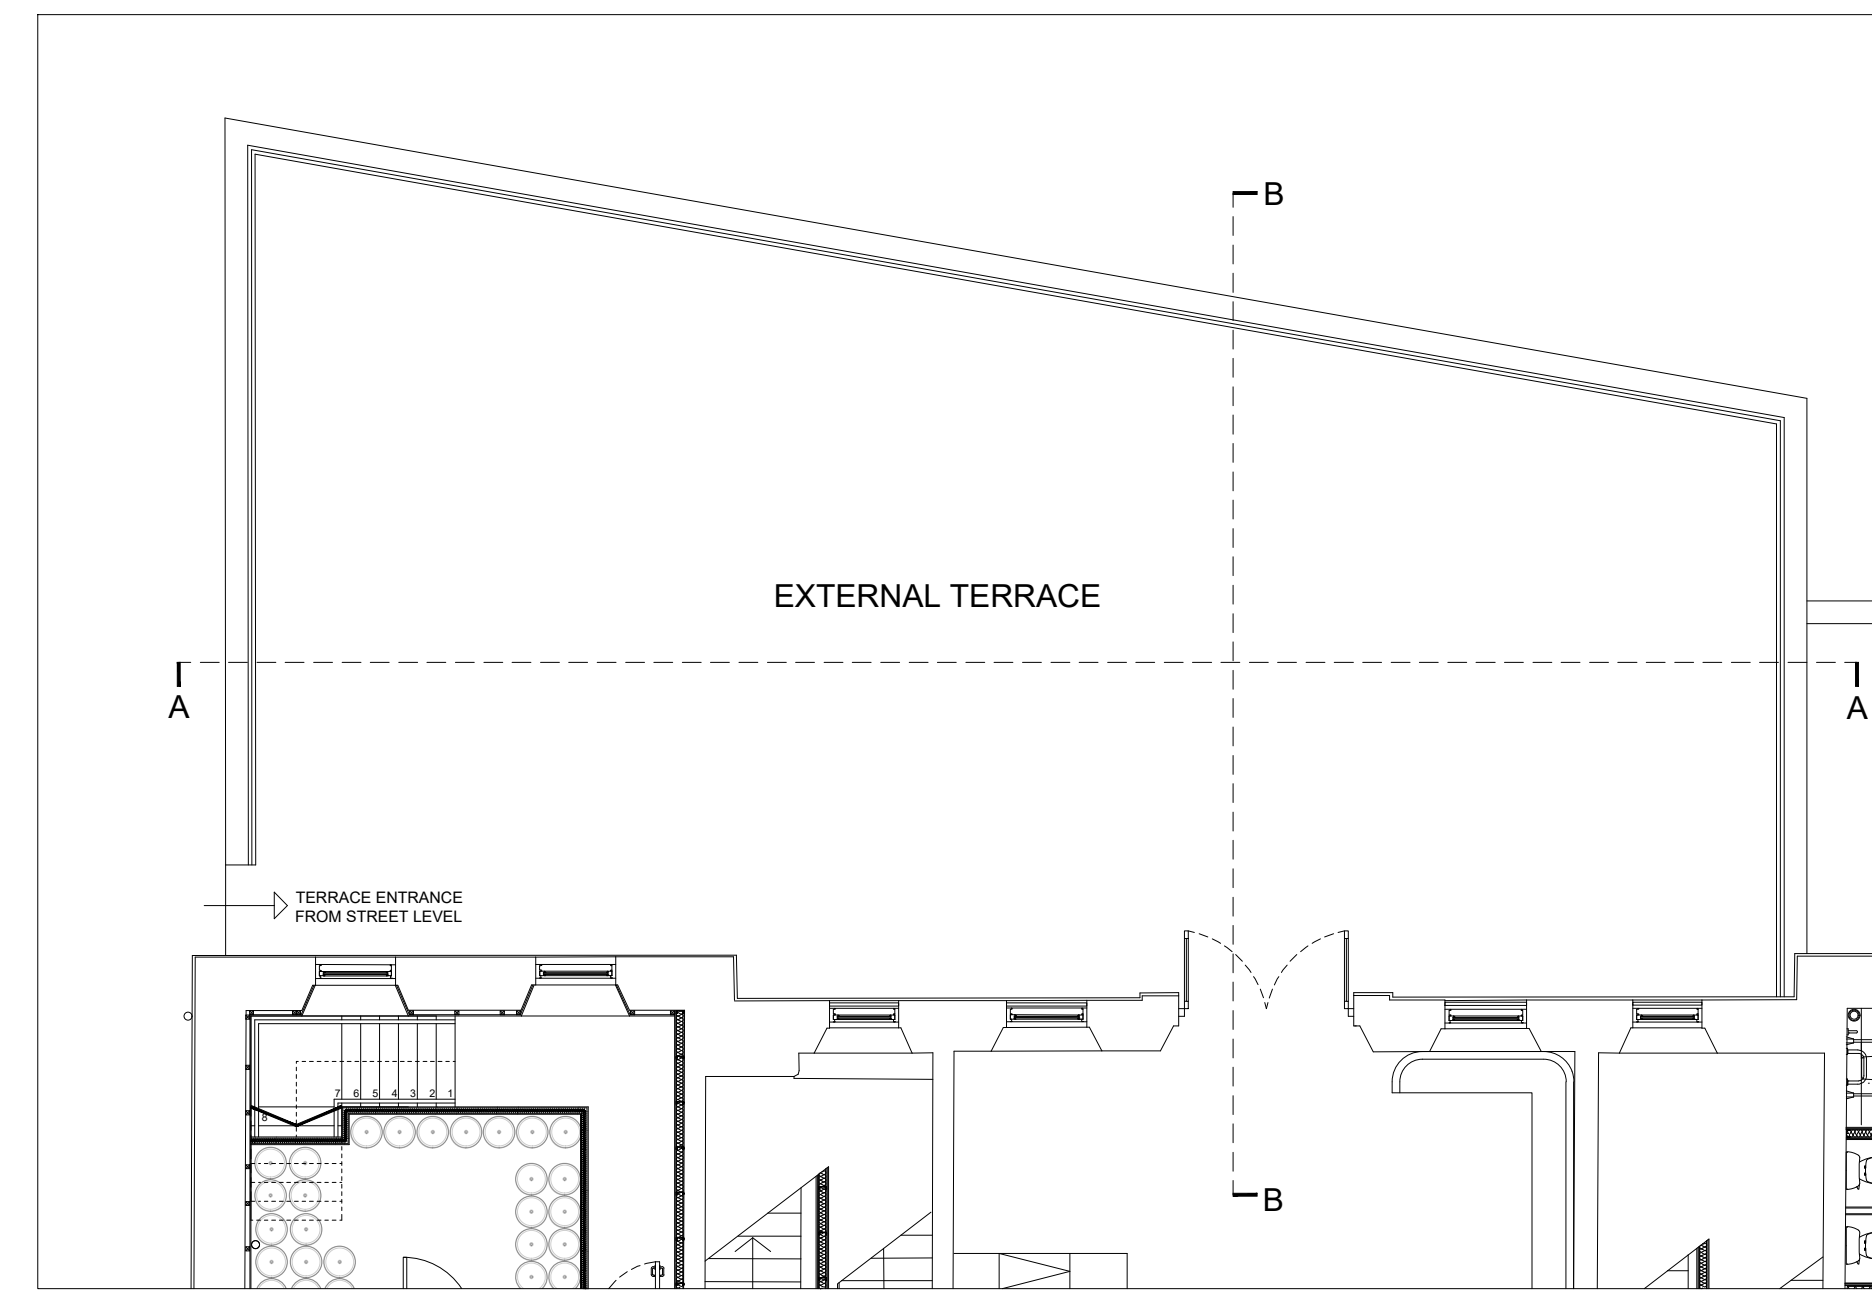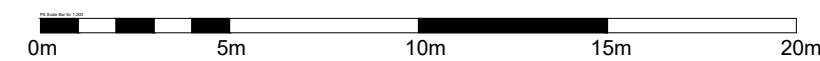

external terrace plan - as existing

scale 1: 100 @ A1

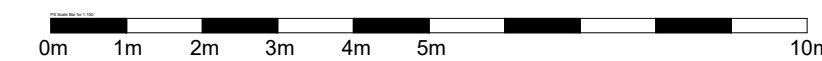

DO NOT SCALE FROM DRAWINGS. USE GIVEN DIMENSIONS ONLY. ALL DIMENSIONS TO BE VERIFIED AND AGREED WITH ARCHITECT IN ACCORDANCE WITH SITE CONDITIONS PRIOR TO THE COMMENCEMENT OF ANY WORKS.

ALL SURFACE DRAWINGS ARE TO BE READ IN CONJUNCTION WITH MECHANICAL AND ELECTRICAL ENGINEERS AND STRUCTURAL ENGINEERS DRAWINGS, DETAILS AND SPECIFICATIONS WHERE RELEVANT.

ALL WORKS TO BE TO THE RELEVANT BRITISH STANDARD CODE OF PRACTICE AND MANUFACTURERS WRITTEN RECOMMENDATIONS.


ALL WORKS INCLUDING DEMOLITIONS TO BE EXECUTED SO AS NOT TO IMPAIR THE STABILITY OR ENDANGER THE BUILDING. ADJACENT WORKS, PERSONNEL OR THIRD PARTIES. ALL IN ACCORDANCE WITH ALL HSE AND STATUTORY AUTHORITIES RECOMMENDATIONS.

ELECTRICAL INSTALLATION TO COMPLY WITH CURRENT IET WIRING REGULATIONS AND WITH B.S. 7671 - 2018 INCLUDING ANY AMENDMENTS. HEATING AND VENTILATION TO SPECIALIST CONTRACTORS DESIGN TO COMPLY TO LATEST CIBSE GUIDELINES.

ALL NEW DRAINAGE TO BE CARRIED OUT STRICTLY IN ACCORDANCE WITH B.S. EN 12056-2: 2000 (SANITARY PIPEWORK), BS EN 752-3: 1997, BS EN 752-4: 1998 BS EN 1610: 1998 (DRAINAGE SYSTEM OUTWITH A BUILDING).

ALL GLAZING, GLASS, WINDOWS DOORS AND SCREENS TO COMPLY FULLY WITH B.S. 6262 AND B.S. 6206.

ALL MATERIALS AND COMPONENTS TO BE 'FIT FOR PURPOSE' AND IN FULL COMPLIANCE WITH THE CURRENT TECHNICAL STANDARDS.

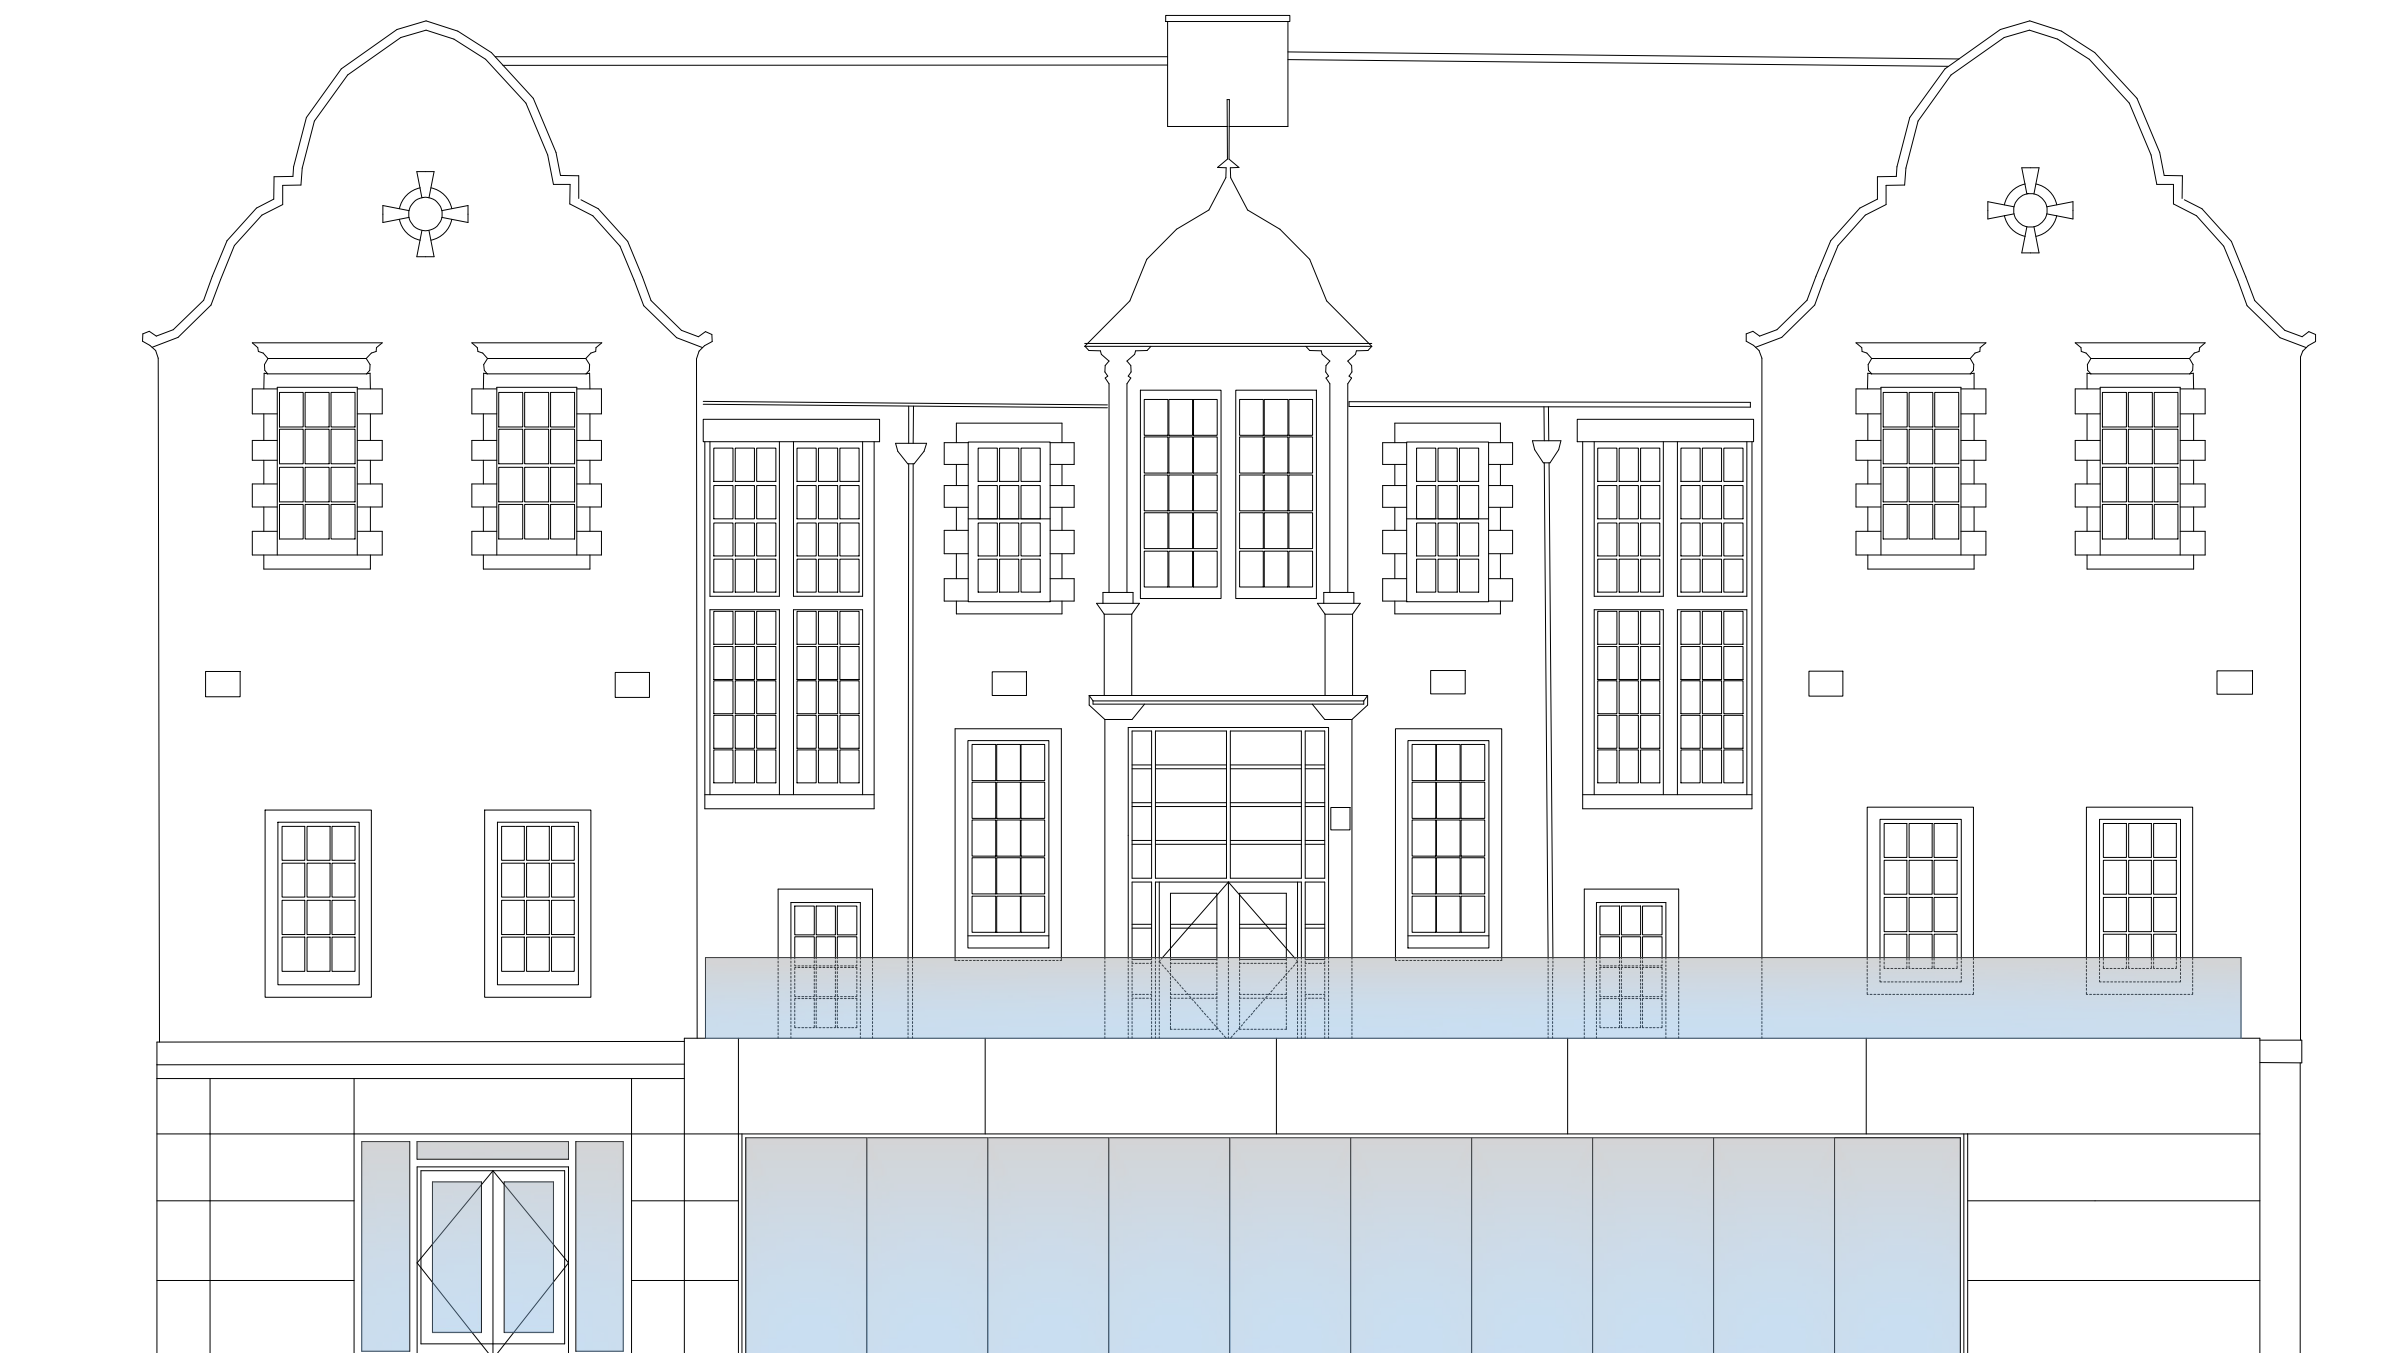


front elevation - as existing

scale 1: 100 @ A1




side elevation - as existing

scale 1: 100 @ A1

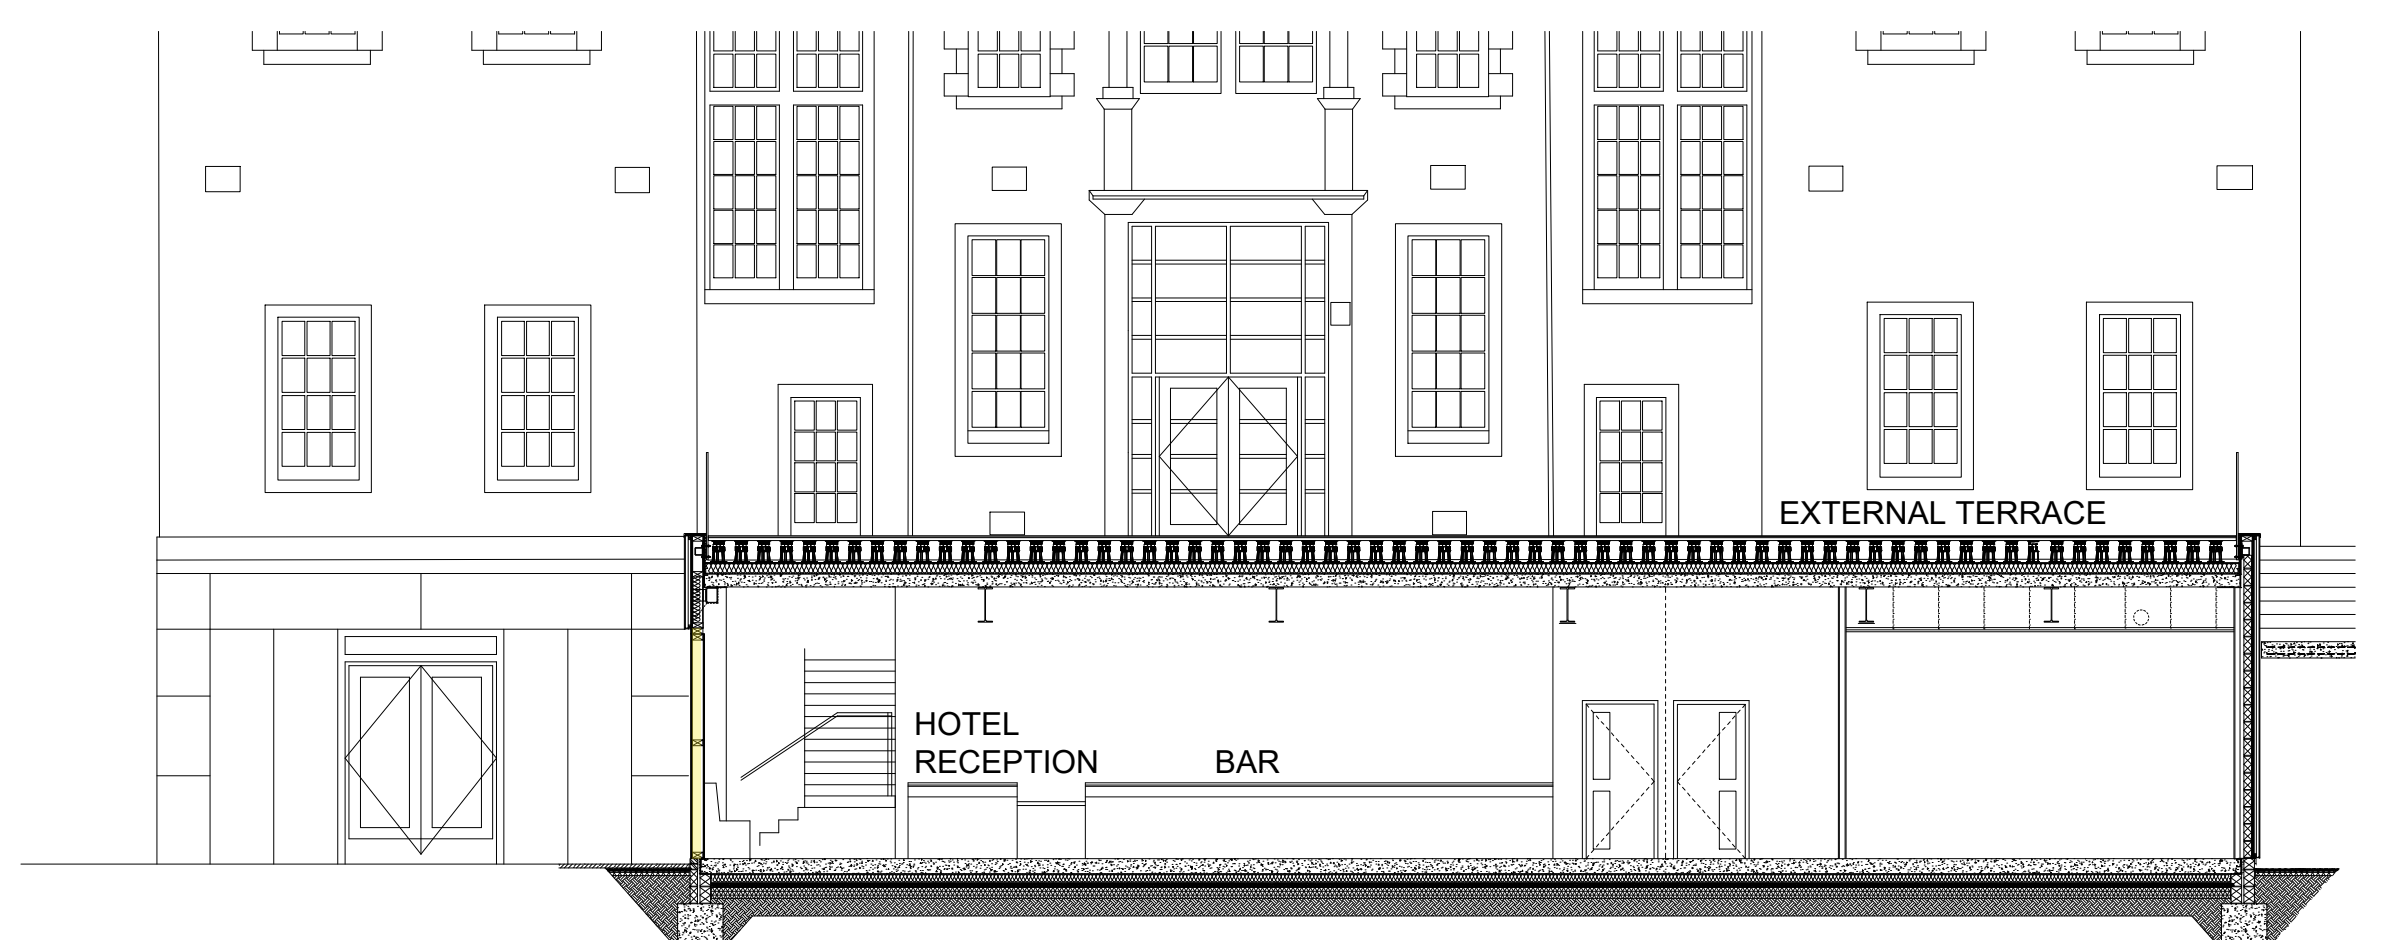

section A-A - as existing

scale 1: 100 @ A1

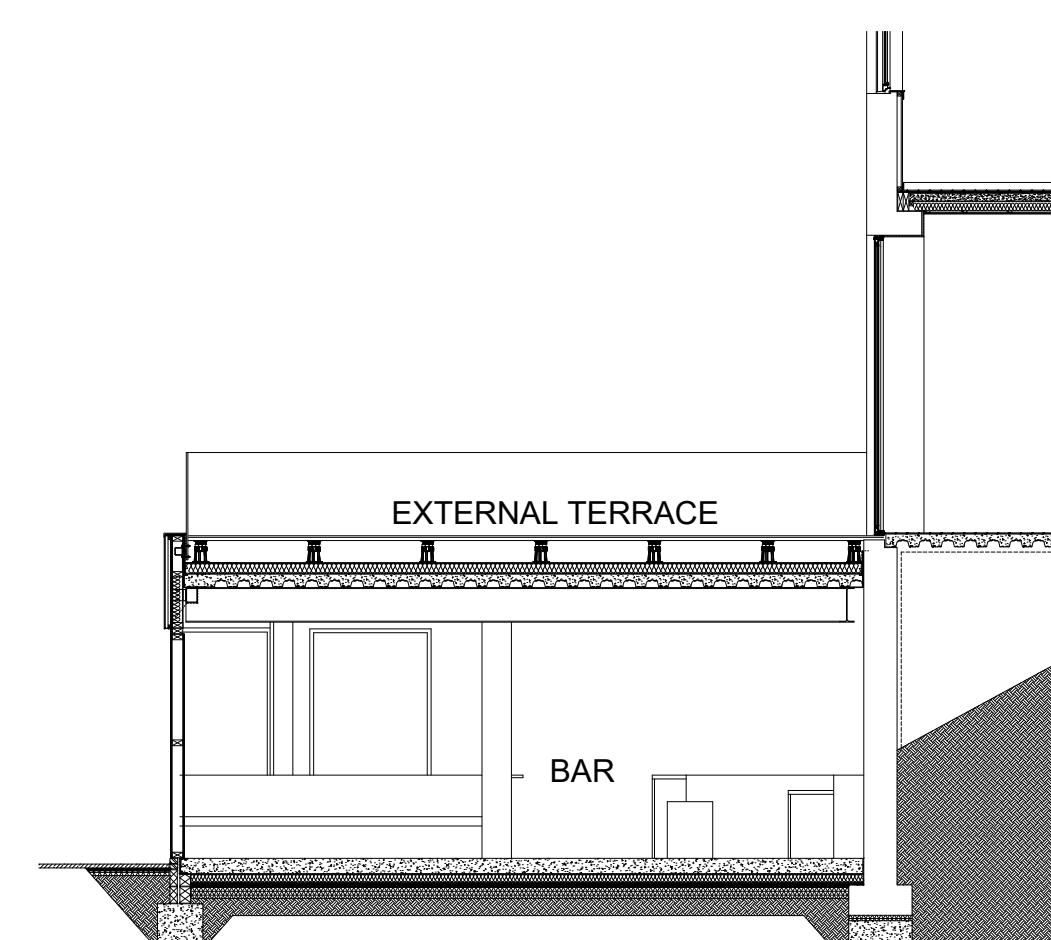

section B-B - as existing

scale 1: 100 @ A1

client: BREWDOG
 project: Brewdog, Cannongate
 location: The Cannongate Venture Building
 New Street, Edinburgh
 EH8 8BH
 drg title: Proposed External Canopy
 Plans and Elevations As Existing


scale: 1:100 & 1:200 @ A1 date: July 2021

drg no: 2908 PL 20

status: PLANNING



surface

Surface - ID Ltd The Mews 12 Fortrose Street GLASGOW G11 5LP
 tel: 0141 342 5448 fax: 0141 337 2244
 mail@surface-id.com www.surface-id.com
 Registered in Scotland No. SC233305

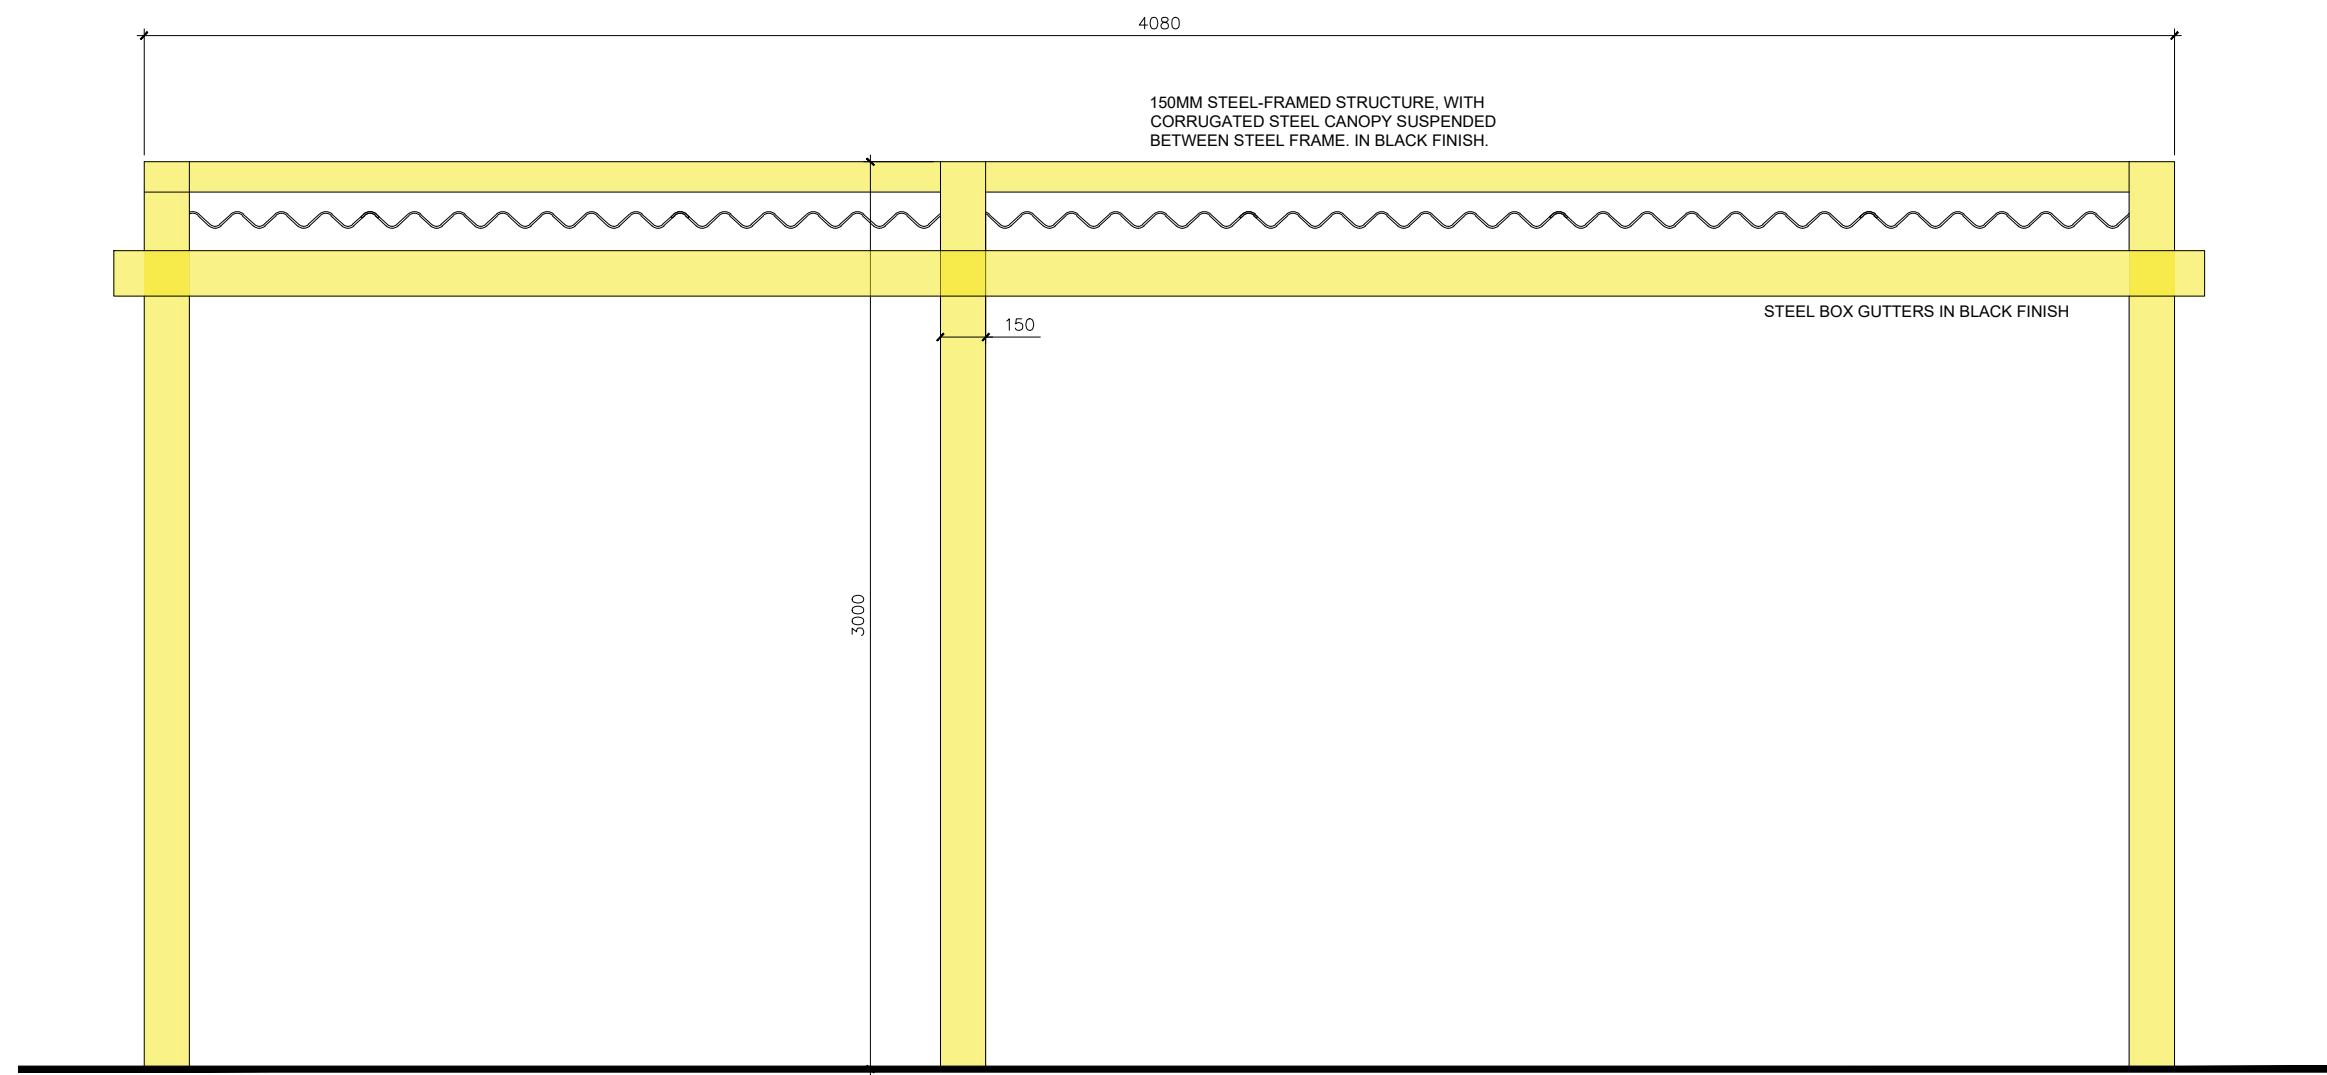


typical section through canopy

scale 1: 25 @ A1

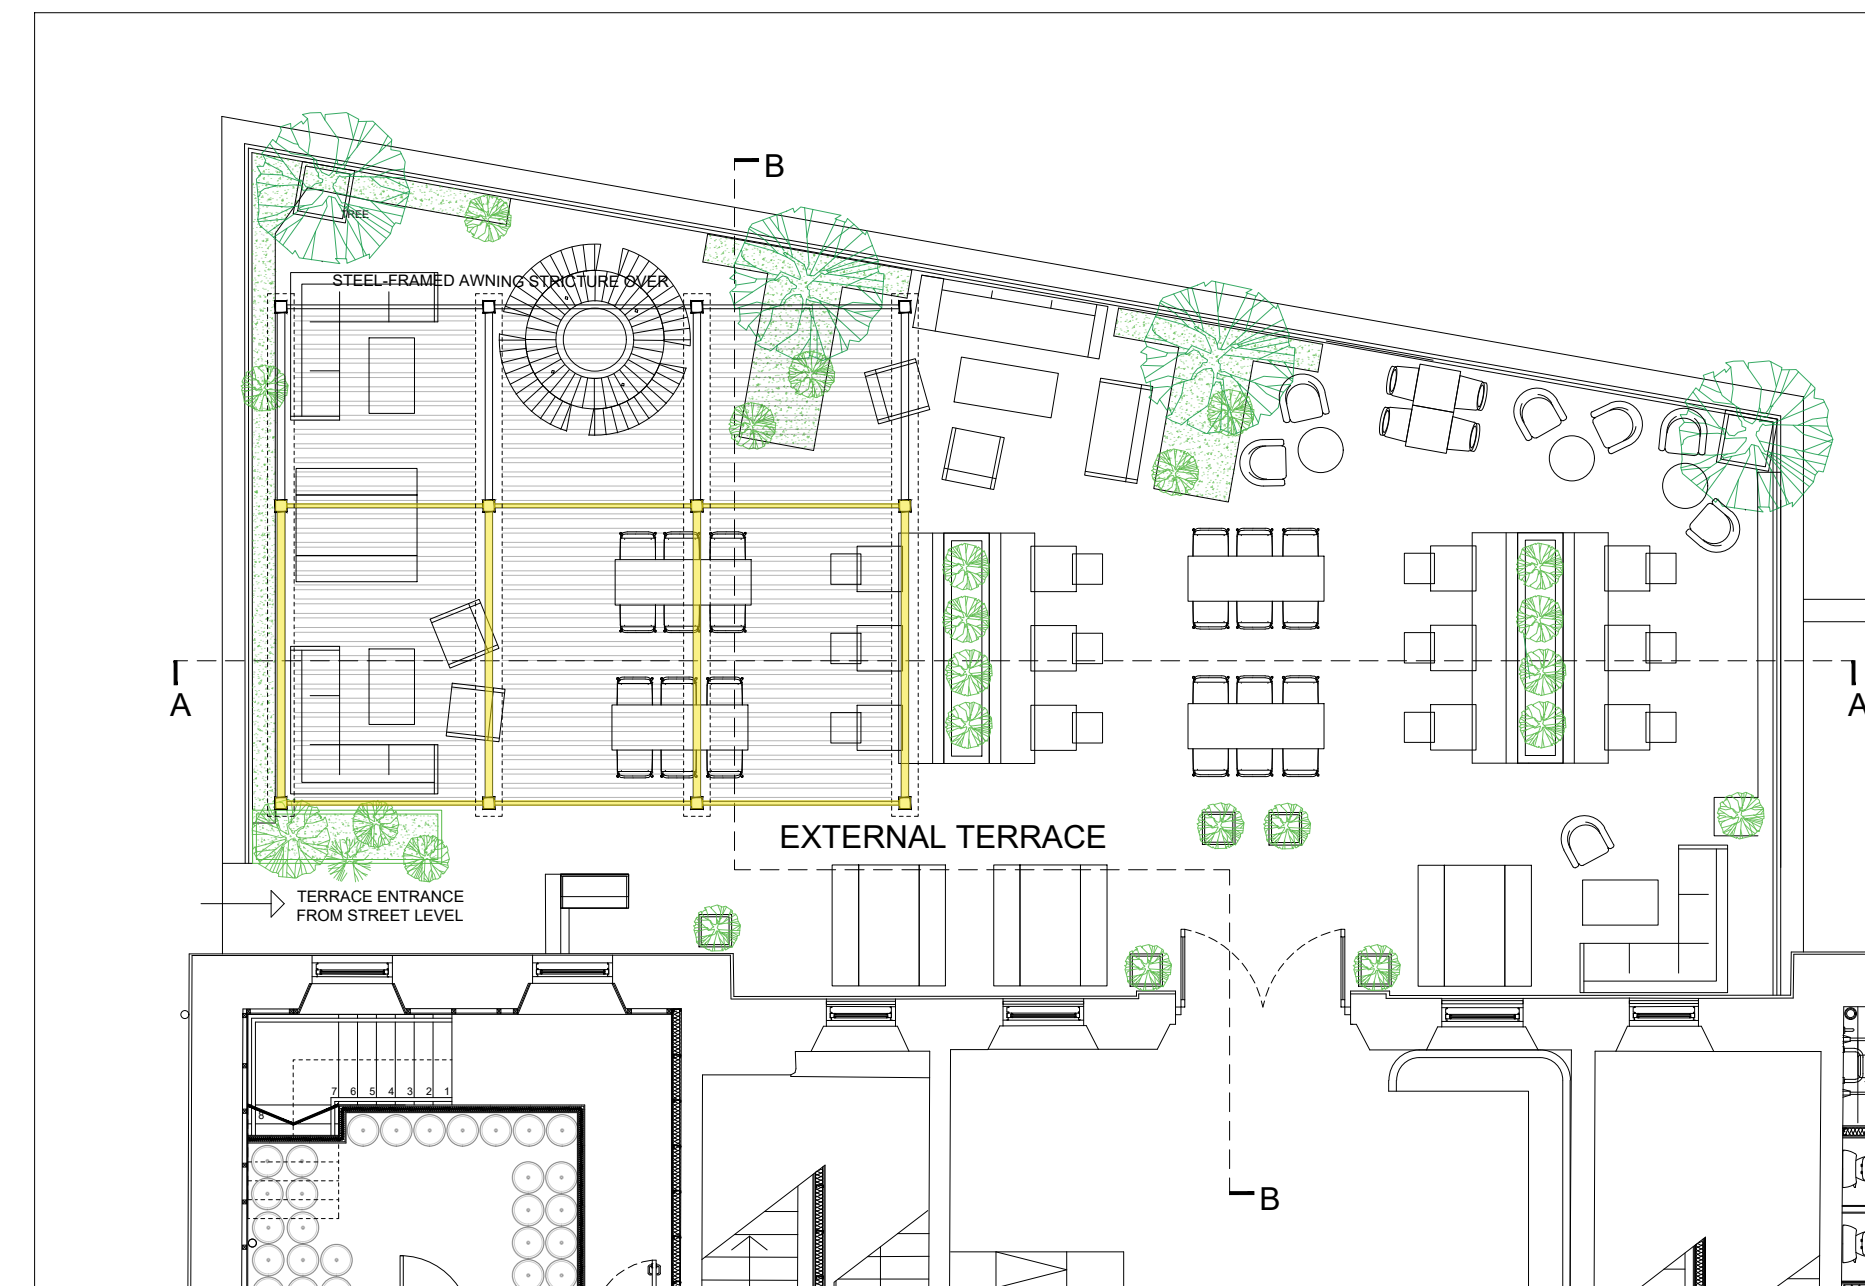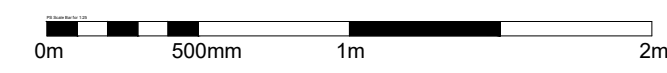

external terrace plan - as proposed

scale 1: 100 @ A1

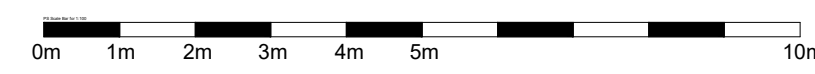

DO NOT SCALE FROM DRAWINGS. USE GIVEN DIMENSIONS ONLY. ALL DIMENSIONS TO BE VERIFIED AND AGREED WITH ARCHITECT IN ACCORDANCE WITH SITE CONDITIONS PRIOR TO THE COMMENCEMENT OF ANY WORKS.

ALL SURFACE DRAWINGS ARE TO BE READ IN CONJUNCTION WITH MECHANICAL AND ELECTRICAL ENGINEERS AND STRUCTURAL ENGINEERS DRAWINGS, DETAILS AND SPECIFICATIONS WHERE RELEVANT.

ALL WORKS TO BE TO THE RELEVANT BRITISH STANDARD CODE OF PRACTICE AND MANUFACTURERS WRITTEN RECOMMENDATIONS.

ALL WORKS INCLUDING DEMOLITIONS TO BE EXECUTED SO AS NOT TO IMPAIR THE STABILITY OR ENDANGER THE BUILDING. ADJACENT WORKS, PERSONNEL OR THIRD PARTIES. ALL IN ACCORDANCE WITH ALL HSE AND STATUTORY AUTHORITIES RECOMMENDATIONS.

ELECTRICAL INSTALLATION TO COMPLY WITH CURRENT IET WIRING REGULATIONS AND WITH B.S. 7671 - 2018 INCLUDING ANY AMENDMENTS. HEATING AND VENTILATION TO SPECIALIST CONTRACTORS DESIGN TO COMPLY TO LATEST CIBSE GUIDELINES.

ALL NEW DRAINAGE TO BE CARRIED OUT STRICTLY IN ACCORDANCE WITH B.S. EN 12056-2: 2000 (SANITARY PIPEWORK), BS EN 752-3: 1997, BS EN 752-4: 1998 BS EN 1610: 1998 (DRAINAGE SYSTEM OUTWITH A BUILDING).


ALL GLAZING, GLASS, WINDOWS DOORS AND SCREENS TO COMPLY FULLY WITH B.S. 6262 AND B.S. 6206.

ALL MATERIALS AND COMPONENTS TO BE 'FIT FOR PURPOSE' AND IN FULL COMPLIANCE WITH THE CURRENT TECHNICAL STANDARDS.




front elevation - as proposed

scale 1: 100 @ A1

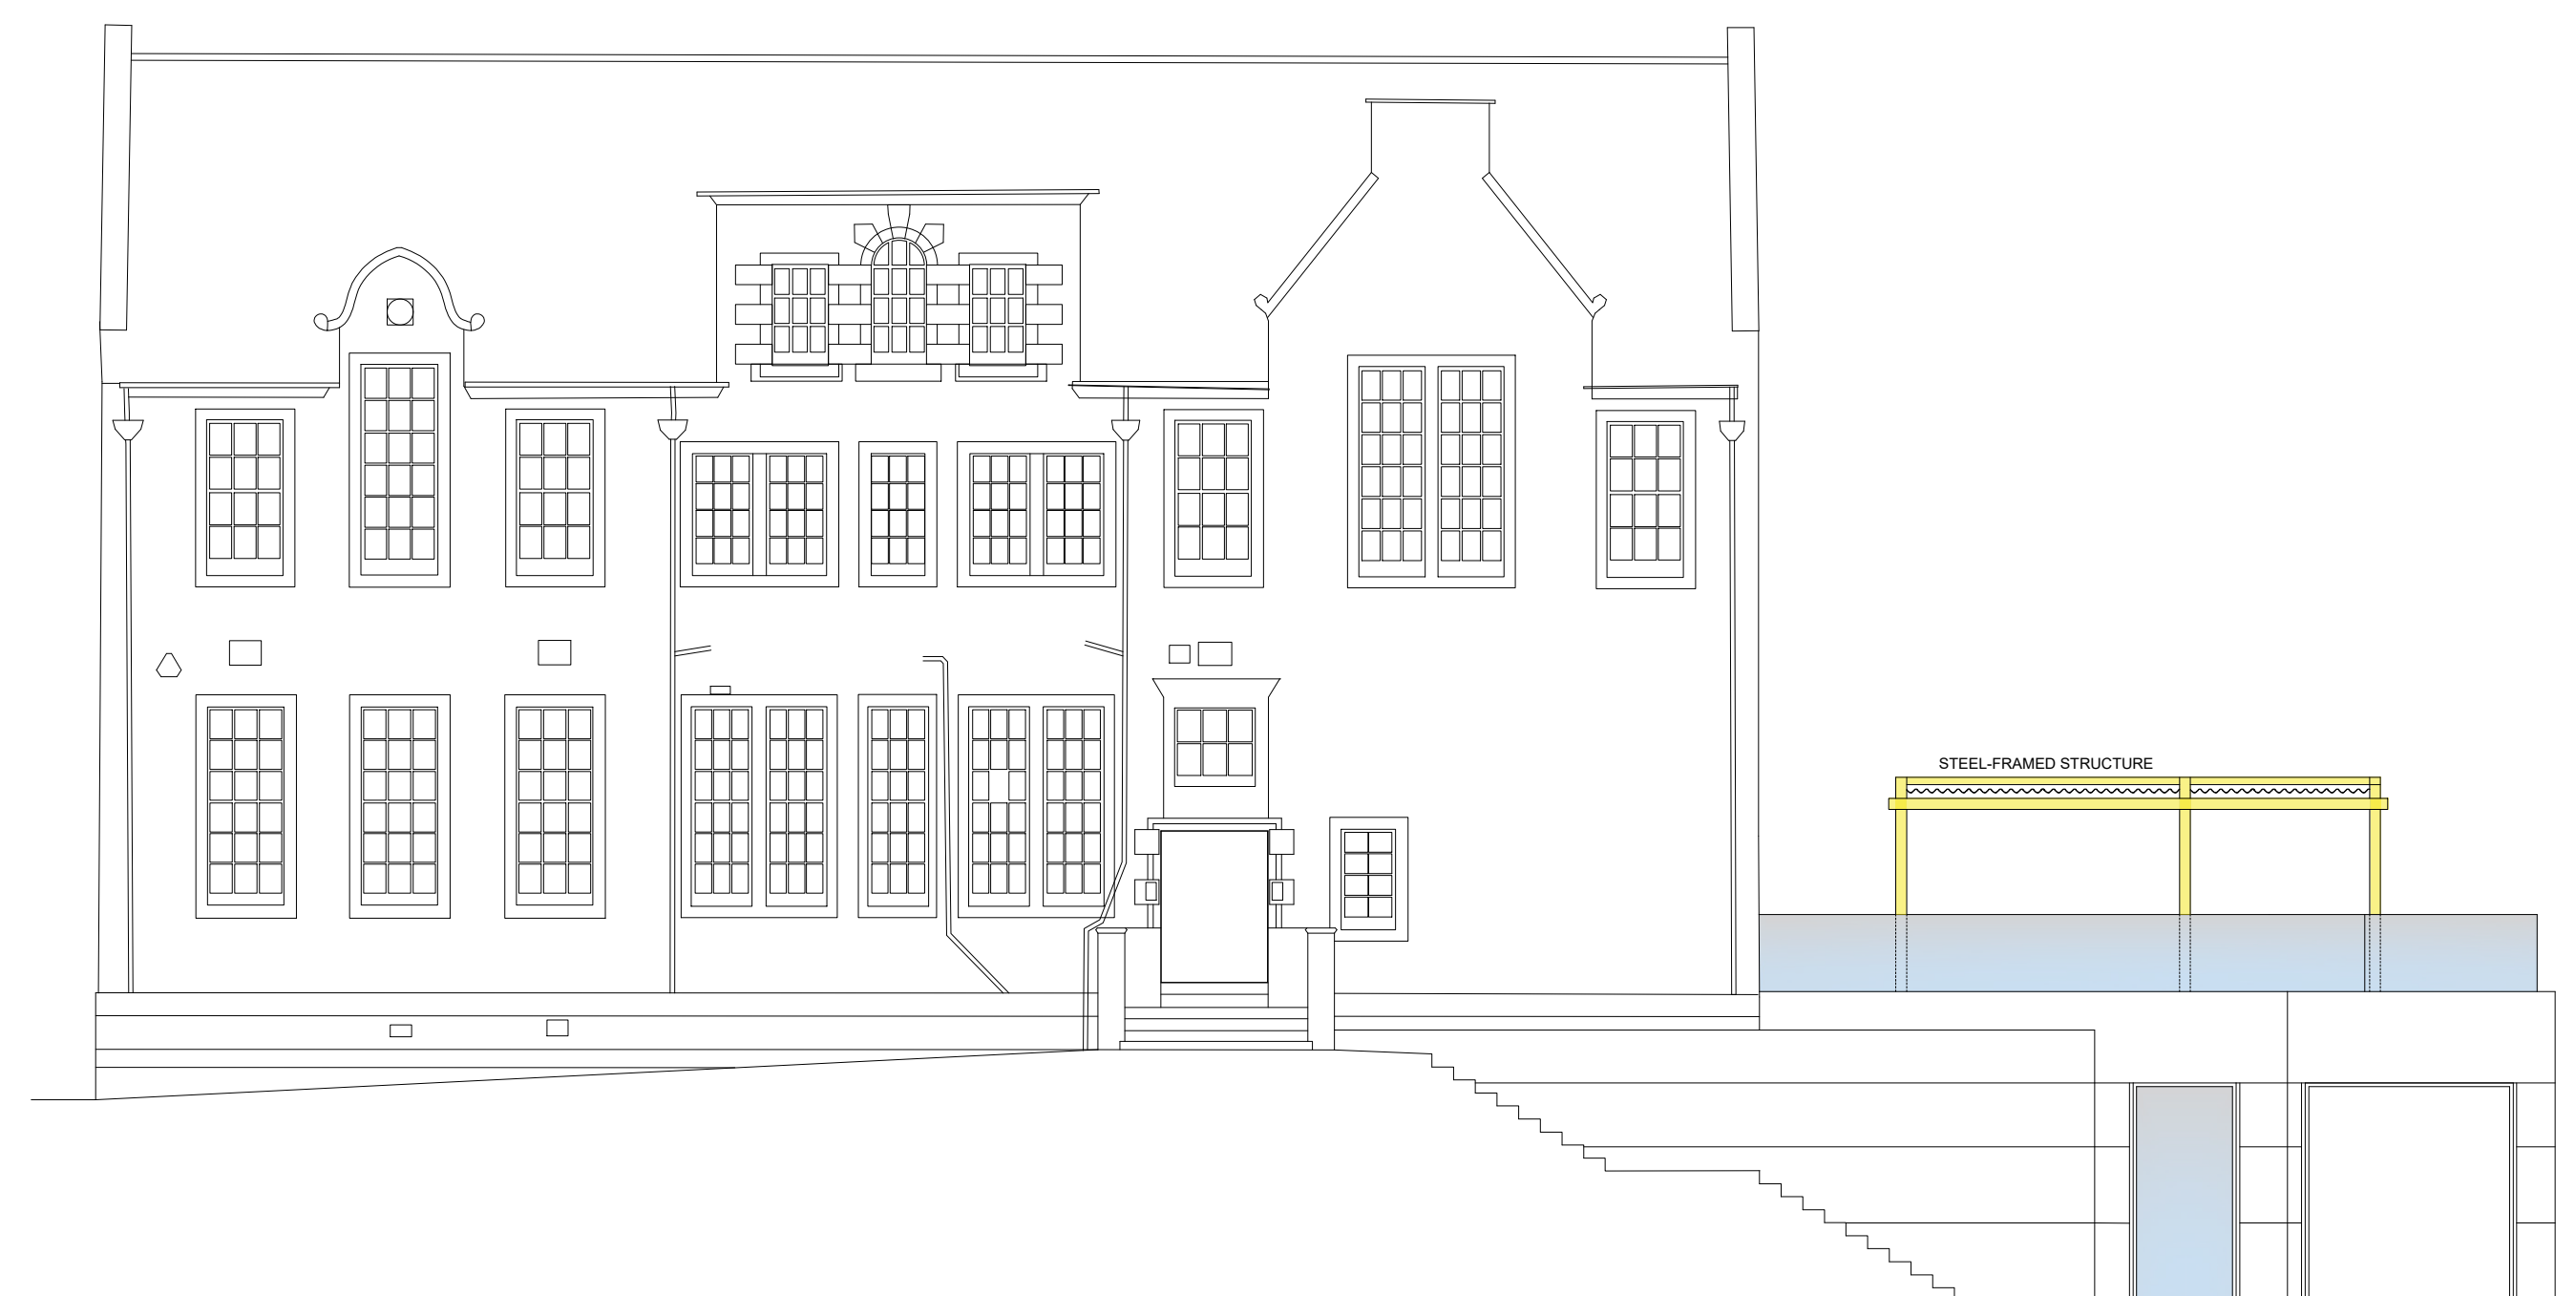


side elevation - as proposed

scale 1: 100 @ A1

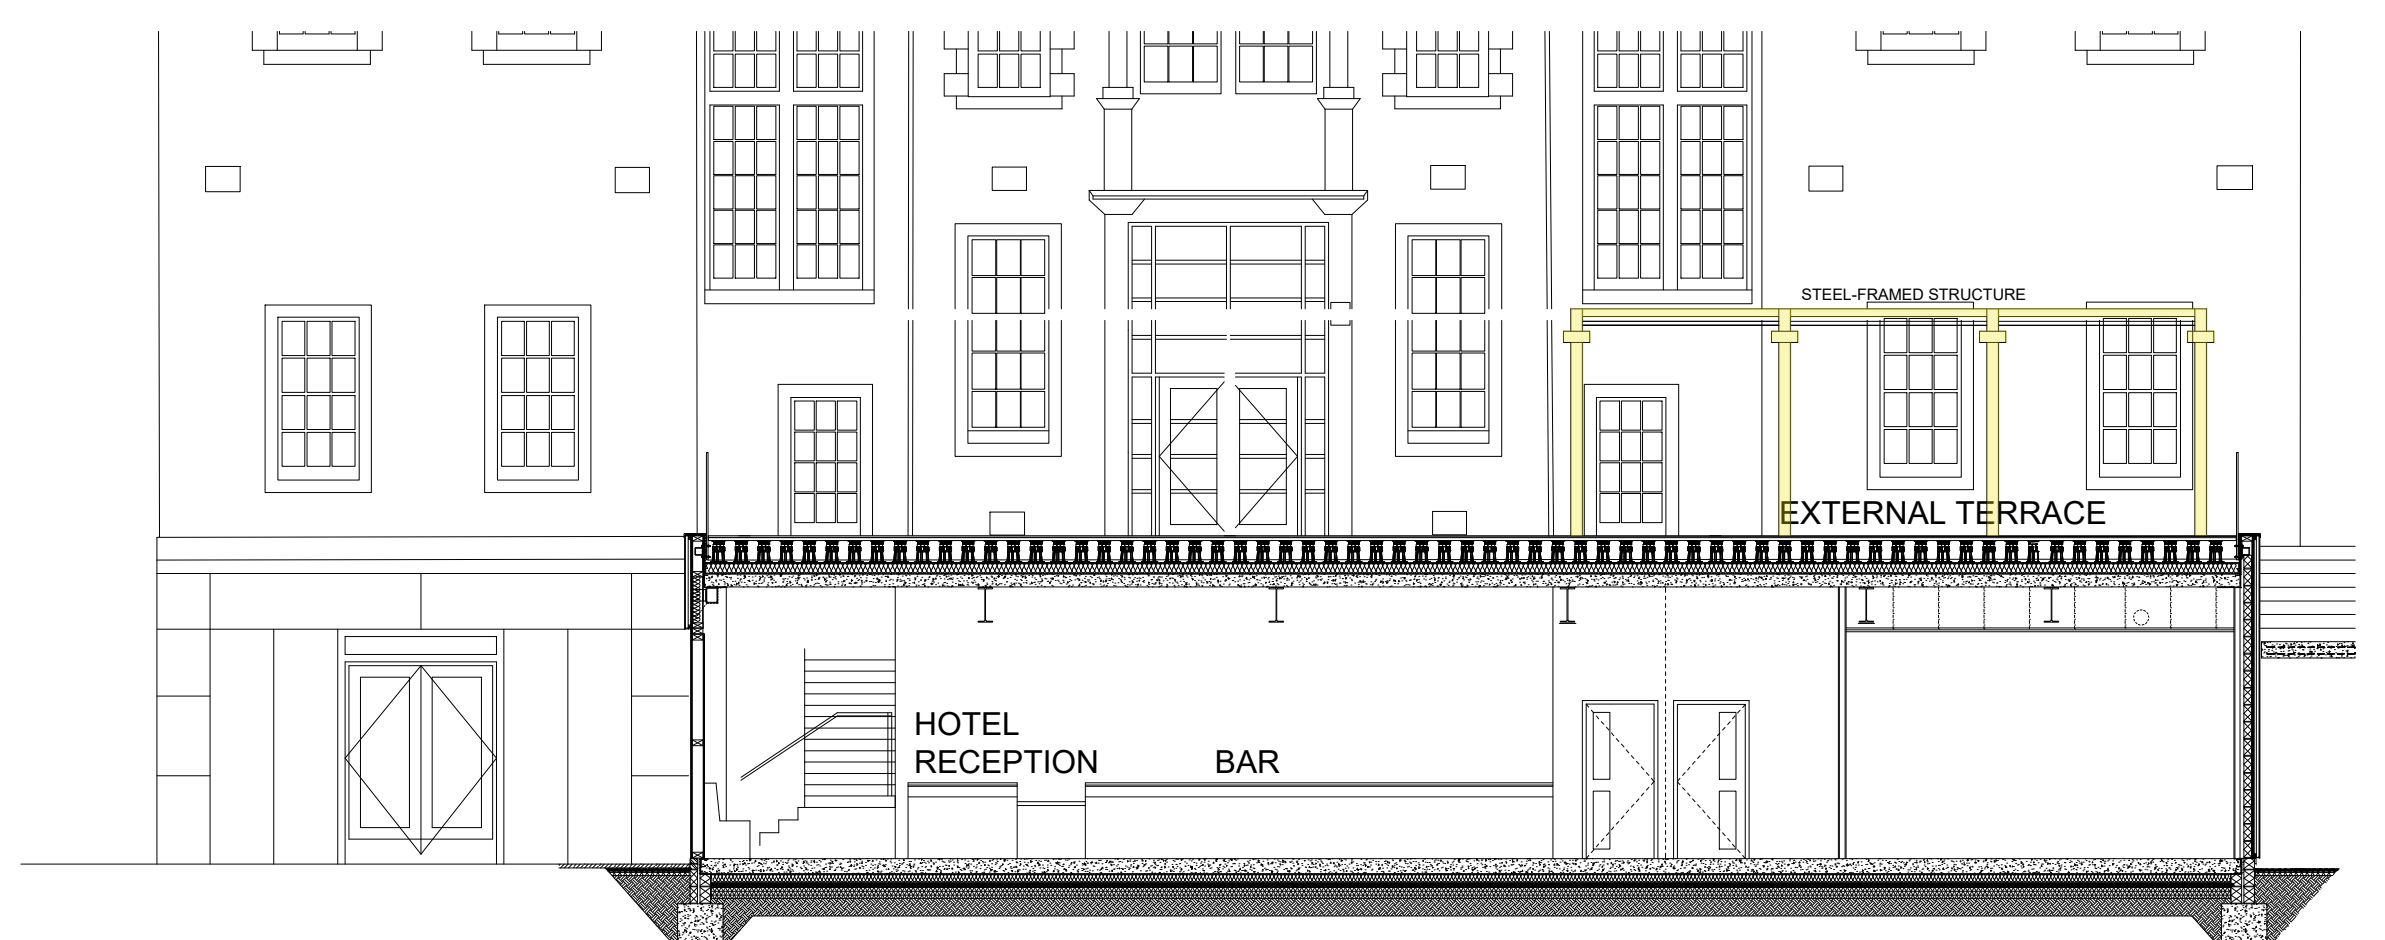

section A-A - as proposed

scale 1: 100 @ A1

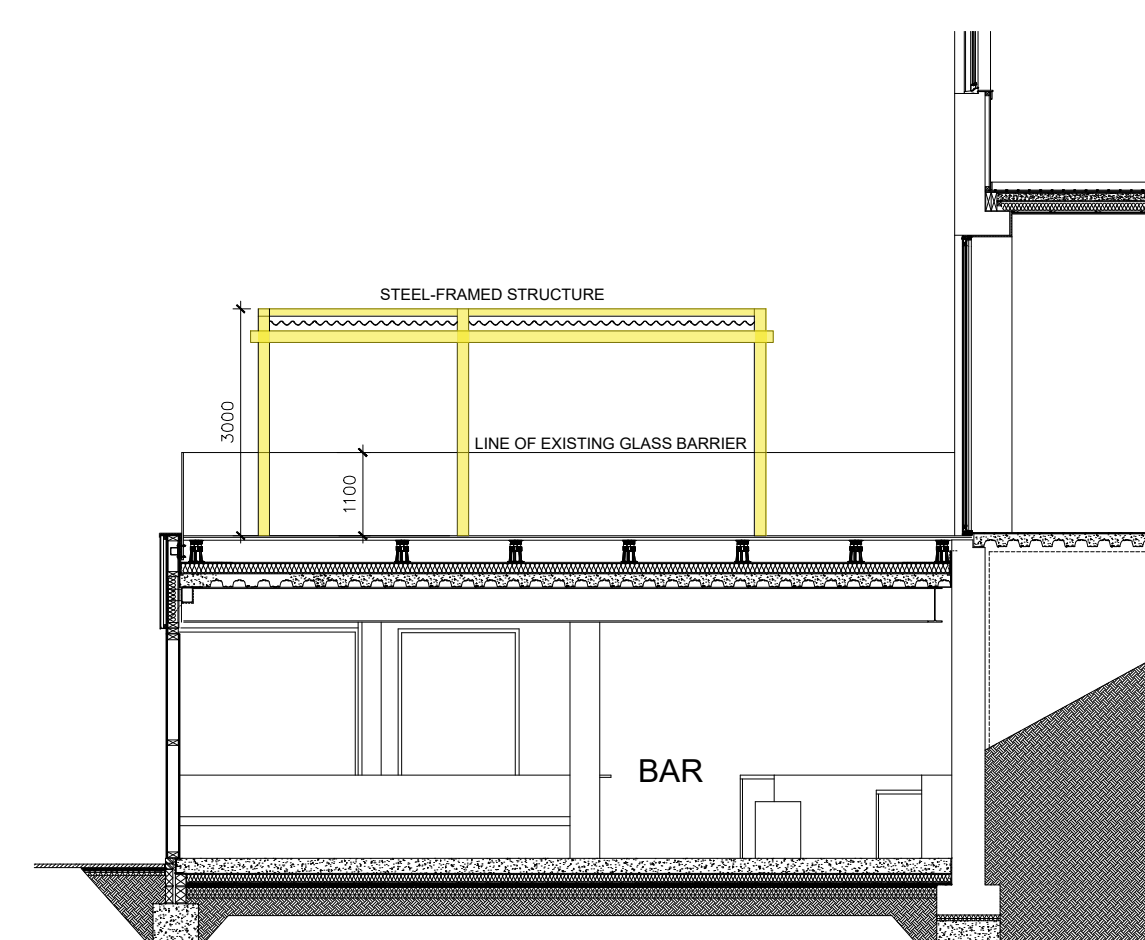

section B-B - as proposed

scale 1: 100 @ A1

client: BREWDOG
 project: Brewdog, Cannongate
 location: The Cannongate Venture Building
 New Street, Edinburgh
 EH8 8BH
 drg title: Proposed External Canopy
 Plans and Elevations As Proposed

scale: 1:100 & 1:200 @ A1 date: August 2022

drg no: 2908 PL 22

status: PLANNING

surface

Surface - ID Ltd The Mews 12 Fortrose Street GLASGOW G11 5LP
 tel: 0141 342 5448 fax: 0141 337 2244
 mail@surface-id.com www.surface-id.com
 Registered in Scotland No. SC233305